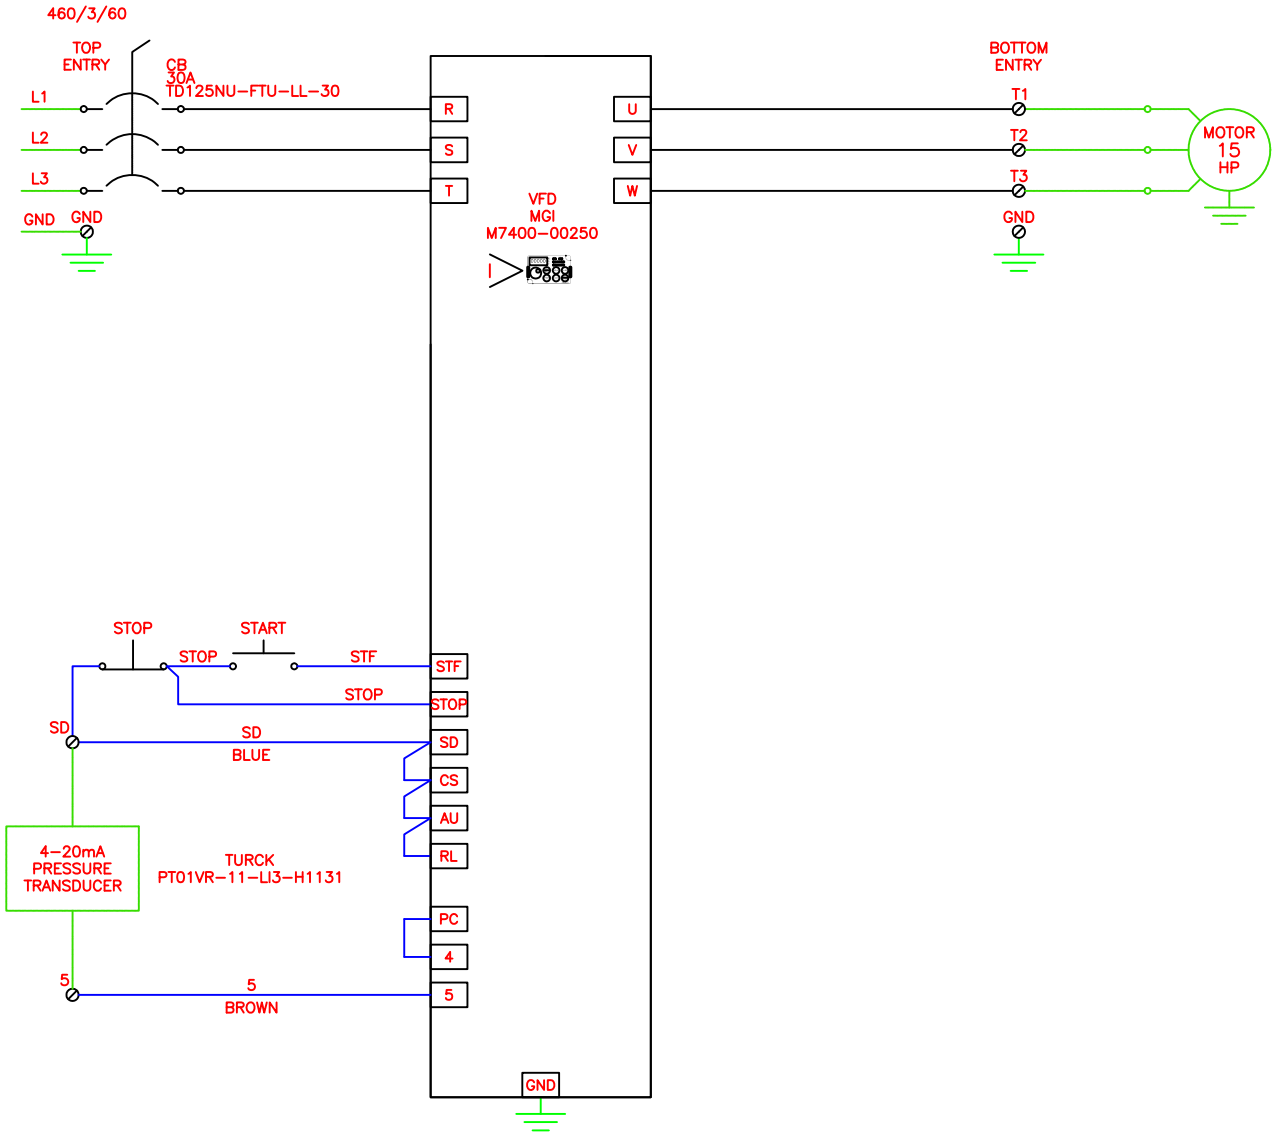

MRS	DRIVE CONNECTION TERMINAL
888	DEVICE CONNECTION TERMINAL
888	TERMINAL NOT FOR CUSTOMER CONNECTION
888	TERMINAL FOR CUSTOMER CONNECTION
D	LOCATED ON ENCLOSURE DOOR
I	LOCATED INSIDE ENCLOSURE
R	LOCATED REMOTE FROM ENCLOSURE
C	LOCATED IN RESISTOR CAGE

	ARROW SUPPLIED ENCLOSURE WIRING
	CUSTOMER SUPPLIED ENCLOSURE WIRING
	ARROW SUPPLIED FIELD WIRING
	CUSTOMER SUPPLIED FIELD WIRING
OUTPUT_DESCRIPTION PLC-OUT Y####	SUPPLIED PLC OUTPUT
INPUT_DESCRIPTION PLC-IN X####	SUPPLIED PLC INPUT
OUTPUT_DESCRIPTION PLC-OUT Y####	CUSTOMER PLC OUTPUT
INPUT_DESCRIPTION PLC-IN X####	CUSTOMER PLC INPUT

ENCLOSURE	TYPE	COOLING	BUS BAR RATING	HEIGHT	WIDTH	DEPTH
	NEMA1	VENTED	NONE	24	20	8

PART NUMBER

REV.	DATE	DESCRIPTION
1	13-NOV-09	***** AS BUILT *****
0	02-NOV-09	ORIGINAL DRAWING ISSUE

CUSTOMER NAME

CUSTOMER DRAWING NUMBER

AUTOVAC INDUSTRIAL VACUUM SYSTEMS

TOLL FREE NUMBER - 1-888-628-8682

EMAIL: SALES@AUTOVACINC.COM - WWW.AUTO-VAC.COM

AUTOVAC Industrial Vacuum & Air Systems

PLANT

TITLE 15HP 460VAC VFD PACKAGE

SUBTITLE WIRING DIAGRAM

SCALE NONE | DRAWN LHK

DATE 02-NOV-09 | CHECKED

B01129221

1